WHITONIA
6200 DWT PRODUCT TANKER

GENERAL INFORMATION

Description:	6200 DWT Double Hull Tanker
Built:	2006
Flag:	Douglas
Call Sign:	MPUN5
IMO:	9342607
Communication:	A1 + A2
Class:	100 A1, Double Hull, ESP, LI, Flash Point >60, LMC
Trading Area:	English Channel & North European Coastal Service East of Land's End & Btw Brest & Elbe in reasonable weather
Summer DWT:	7500

TANK ARRANGEMENT Capacities given at 100%

SLOP 165.6 m^3	TANK 5 (Port) 253.1 m^3 Gas Oil	TANK 4 (Port) 857.8 m^3 Fuel Oil	TANK 3 (Port) 857.8 m^3 Fuel Oil/Gas Oil	TANK 2 (Port) 857.8 m^3 Fuel Oil	TANK 1 (Port) 595.9 m^3 Gas Oil
	TANK 5 (Stbd) 253.1 m^3 Gas Oil	TANK 4 (Stbd) 857.8 m^3 Fuel Oil	TANK 3 (Stbd) 857.8 m^3 Fuel Oil/Gas Oil	TANK 2 (Stbd) 857.8 m^3 Fuel Oil	TANK 1 (Stbd) 595.9 m^3 Gas Oil

CARGO EQUIPMENT

Cargo pumps:	Bornemann 1 x G.O 150 M^3/hr 2 x F.O 500 M^3/hr (each)
Max Loading Rate:	1000 M^3
Max Discharge Rate:	1000 M^3
Tanks coating:	Part coated
Boiler:	Wanson Thermal Fluid
Ballast Pumps:	Desmi 2 x 300 M^3/hr
Ballast Capacity:	3041.5 M^3
Tank Monitoring:	ENRAF

DIMENSIONS

L.O.A:	101.08 M
L.B.P:	95.20 M
Beam:	18.00 M
Depth:	8.80 M
GT/NT:	4292/1963
Loaded Draft:	6.30 M

MACHINERY/SPEED/CONSUMPTION

Main Engines:	2 x Yanmar 750 Kw @ 1500 RPM
Aux Engines:	2 x CAT 3412 @ 500 Kw 1 x CAT 3406 @ 250 Kw
Propeller:	Twin Azimuth thrusters
Bow Thruster:	1 x tunnel thruster @ 450 Kw
Emerg harbour Gen:	KVA
Crane:	16 M x 3 Tonne & 18 M x 1 Tonne
Speed:	9 Knots @ 3 Tonnes
Bunker Capacity:	130 M^3
FW Capacity:	109 M^3

CARGO TANKS
Capacities given at 95%

HFO:	2s & 4s = 3,260 M^3 2s, 3s & 4s = 4,889 M^3
Gas Oil:	1s & 5s =1,613 M^3 1s, 3s & 5s = 3,408 M^3

Total cargo capacity: 6,503 M^3

All details given in good faith but not guaranteed

JOHN H. WHITAKER (TANKERS) LTD
TEL: 00 (44) 01482 595300 | EMAIL: info@whitaker-tankers.co.uk | FAX: 00 (44) 01482 226270

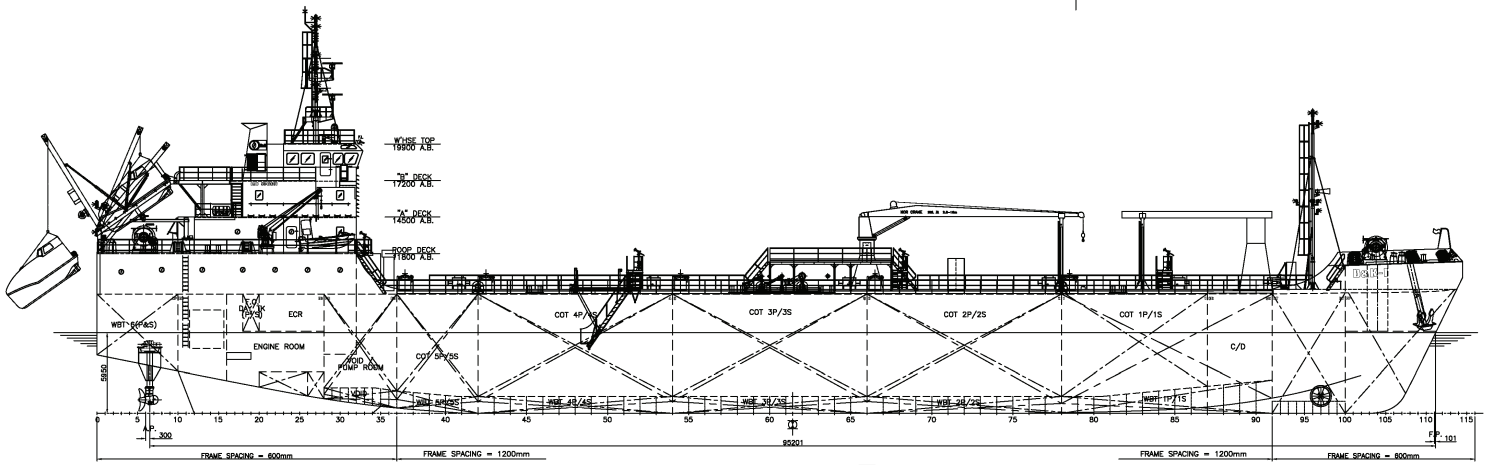

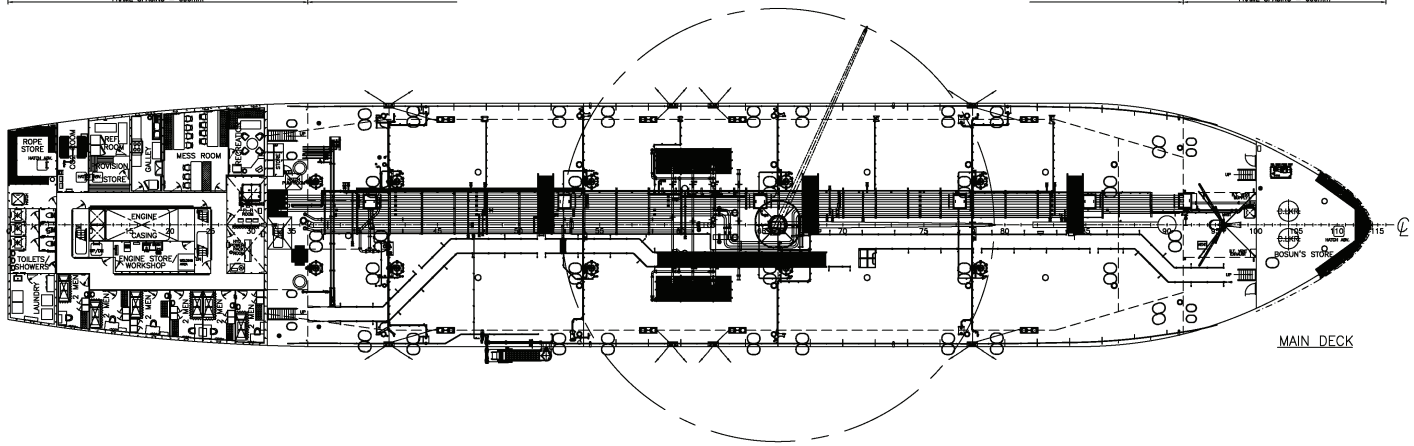

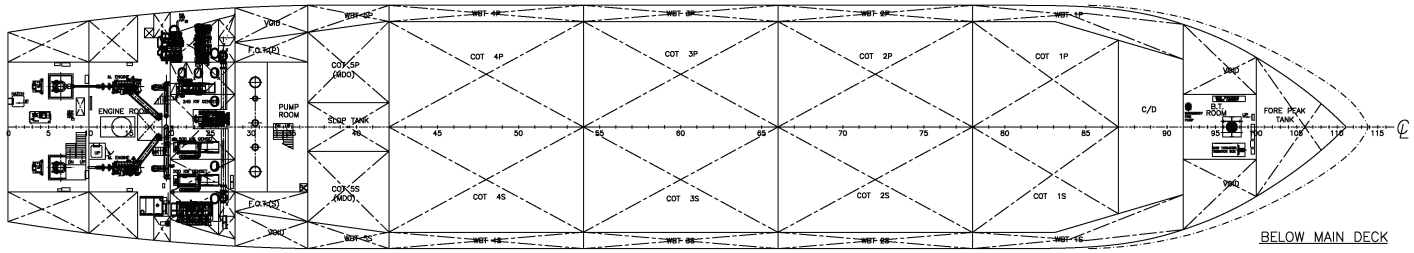

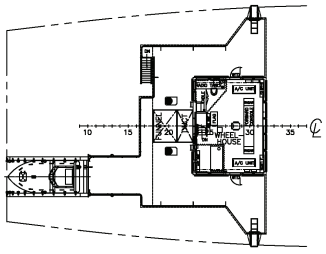

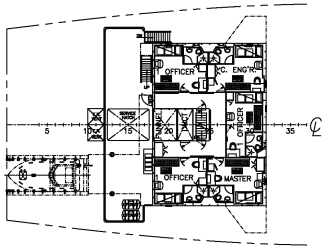

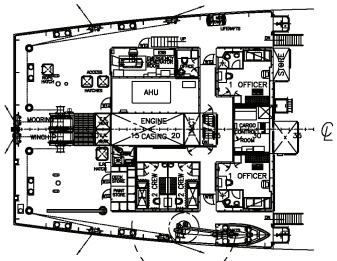

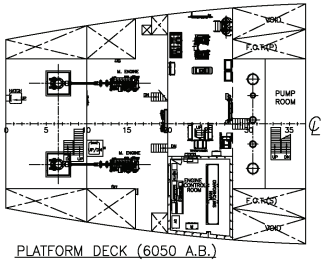

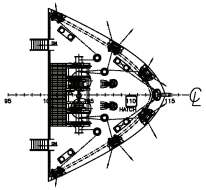

PRINCIPAL PARTICULARS:

LENGTH O.A.	101.084 m
LENGTH B.P.	95.20 m
BREADTH MLD.	18.00 m
DEPTH MLD.	8.80 m
DESIGN DRAFT	5.95 m
SCANTLING DRAFT	6.70 m
SERVICE SPEED	8 KNOTS AT 85% MCR
ACCOMMODATION	7 OFFICERS + 16 CREW
PROPULSION	TWIN AZIMUTH THRUSTERS

TANK CAPACITY (APPROX.)

CARGO OIL (MDO)	500 m³
CARGO OIL (IFO)	6300 m³
SLOP TANK	150 m³
SHIP'S FUEL OIL	130 m³
FRESH WATER	109 m³
LUB OIL	11 m³

CLASS NOTATION:

+100A1 DOUBLE HULL OIL TANKER, FOR CARRIAGE OF BUNKER FUEL, F.P. EXCEEDING 60°C, ARABIAN GULF COASTAL SERVICE (ARABIAN GULF AND GULF OF OMAN, SHIP SERVICE FACTOR = 0.8), ESP, LI +LMC

REV	DATE	STATUS	PREPARED	CHECKED	APPROVED	CLIENT APPROVED
X2	26.10.06	AS BUILT	A.DELA CRUZ	H. PETROV	R.PANICKER	
X1	18.05.06	AS BUILT	A.DELA CRUZ	H. PETROV	R.PANICKER	
C3	04.05.06	FOR COMMENTS/APPROVAL	A.DELA CRUZ	M.TERNSBY	R.PANICKER	
C2	20.04.05	AS PER OWNER'S COMMENTS	J.CABREZA	G.JAYASANKAR	W.KRUK	
C1	30.01.05	FOR COMMENTS / APPROVAL	J.CABREZA	G.JAYASANKAR	W.KRUK	
P1	06.01.05	PRELIMINARY ISSUE	E.A. MOLINO	A.CIDAMBARAM	M. HARVEY	

DUBAI DRYDOCKS حوض دبي الجاف

"COPYRIGHT OF DUBAI DRYDOCKS, U.A.E, WHOSE PROPERTY THIS DOCUMENT REMAINS. NO PART THEREOF MAY BE DISCLOSED, COPIED, DUPLICATED OR IN ANY OTHER WAY MADE USE OF, EXCEPT WITH THE PRIOR APPROVAL OF DUBAI DRYDOCKS, U.A.E."

PROJECT: 6200T DWT BUNKER TANKER

SCALE: 1:200 (A1)

TITLE: GENERAL ARRANGEMENT

PROJECTION:

DD REFERENCE NO	ENGINEERING REF. No. / HULL No.	DRAWING / DOCUMENT NO	SHEET
S9925	NB41	NB41/A/D/001	1/1